


PROFESSIONAL INVOLVEMENT - IS ENGINEERING INVOLVEMENT REQUIRED? Professional Seal Requirements of the National Building Code - 2023 Alberta Edition

Assembly, Detention, Treatment, or Care Occupancies
(Group A & B)

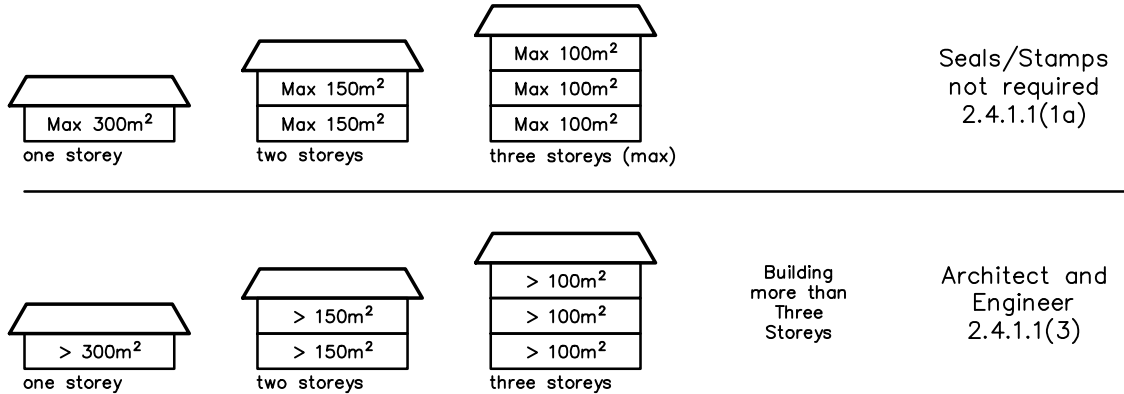


Residential Occupancies
(Group C)

Multi-family dwelling with max 4 units
OR single-family dwelling

Seals/Stamps
not required
2.4.1.1(1b)

Hotel/Motel or similar

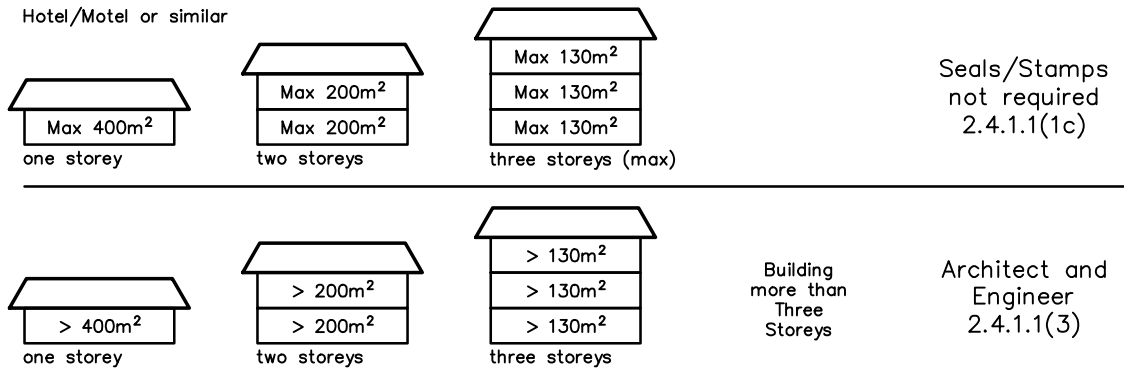

~~5-20 unit Apartment or similar~~

~~>20 unit Apartment or similar apartment with more than three storeys~~

ABILITY OF AN ENGINEER TO ACT AS COORDINATING PROFESSIONAL IN LIEU OF AN ARCHITECT HAS BEEN REMOVED IN THIS VERSION OF THE BUILDING CODE.

~~Architect or
Engineer
2.4.1.1(4a)~~

~~Architect and
Engineer
2.4.1.1(5)~~

THIS FLOWCHART HAS BEEN PUBLISHED AS PUBLIC SERVICE. IT IS NOT INTENDED TO REPLACE PROFESSIONAL ENGINEERING ADVICE. REFER TO THE ALBERTA BUILDING CODE FOR FURTHER REQUIREMENTS, DETAILS, AND EXCEPTIONS. 908 ENGINEERING ASSUMES NO RESPONSIBILITY FOR THE CONTENT HEREIN.

| REV. | DATE | DESCRIPTION |
|------|--------------|--|
| 3 | 22 OCT 2024 | UPDATED TO NATIONAL BUILDING CODE - 2023 ALBERTA EDITION |
| 2 | 23 OCT 2019 | UPDATED TO NATIONAL BUILDING CODE - 2019 ALBERTA EDITION |
| 1 | 09 OCT 2015 | UPDATED ABC(2006) REFERENCES TO ABC(2014) |
| 0 | 31 JULY 2014 | ISSUED FOR PUBLIC USE |

908 Engineering

INCORPORATED

PO Box 20020 Red Deer, AB T4N 6X5
Phone: 403.986.2939 Web: 908eng.com

PROJECT:

PROFESSIONAL INVOLVEMENT CHART

FILE NO:

N/A

DWG NO:

PI 1

PROFESSIONAL SEAL REQUIREMENTS OF ABC 2014

1 OF 2


DRAWN: COB

CHECKED: COB


DATE: 22 OCT 24

PROFESSIONAL INVOLVEMENT - IS ENGINEERING INVOLVEMENT REQUIRED? Professional Seal Requirements of the National Building Code - 2023 Alberta Edition

Business, Personal Services, & Mercantile Occupancies
(Group D & E)

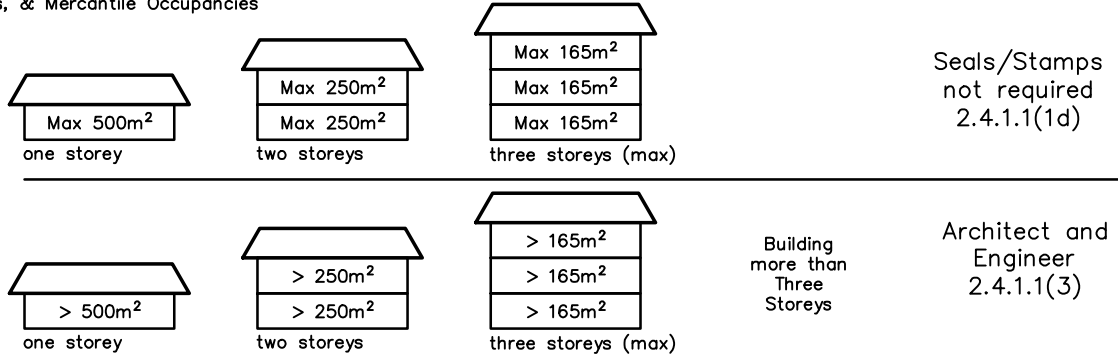

Industrial Occupancies
(Group F)

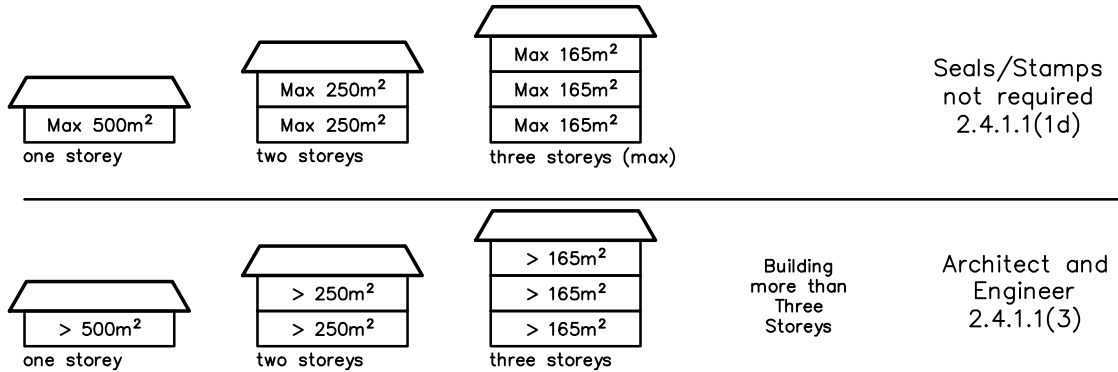

Industrial building larger than maximum area above
but with a designed occupant load of > 28m²/person.

ABILITY OF AN ENGINEER TO ACT AS COORDINATING
PROFESSIONAL IN LIEU OF AN ARCHITECT HAS BEEN
REMOVED IN THIS VERSION OF THE BUILDING CODE.

Industrial major occupancy >
400m² and designed occupant load of > 28m²/person.

~~Architect or
Engineer~~

Architect or
Engineer

Other

Farm buildings not for public use OR
Relocatable industrial camp building

Seals/Stamps
not required
2.4.1.1(1e,1f)

Any building where the size or complexity may give
rise to special safety concerns the authority having
jurisdiction may require seals and/or stamps.

Architect or Engineer
as required
2.4.1.1(4)

Any building other than described above

Architect and
Engineer
2.4.1.1(3)

THIS FLOWCHART HAS BEEN PUBLISHED AS PUBLIC SERVICE. IT IS NOT INTENDED TO REPLACE PROFESSIONAL ENGINEERING ADVICE. REFER TO THE ALBERTA BUILDING CODE FOR FURTHER REQUIREMENTS, DETAILS, AND EXCEPTIONS. 908 ENGINEERING ASSUMES NO RESPONSIBILITY FOR THE CONTENT HEREIN.

| REV. | DATE | DESCRIPTION |
|------|--------------|--|
| 3 | 22 OCT 2024 | UPDATED TO NATIONAL BUILDING CODE - 2023 ALBERTA EDITION |
| 2 | 23 OCT 2019 | UPDATED TO NATIONAL BUILDING CODE - 2019 ALBERTA EDITION |
| 1 | 09 OCT 2015 | UPDATED ABC(2006) REFERENCES TO ABC(2014) |
| 0 | 30 JULY 2014 | ISSUED FOR PUBLIC USE |

908 Engineering

INCORPORATED

PO Box 20020 Red Deer, AB T4N 6X5
Phone: 403.986.2939 Web: 908eng.com

PROJECT:

PROFESSIONAL
INVOLVEMENT CHART

FILE NO:

N/A

DWG NO:

PI 2

PROFESSIONAL SEAL REQUIREMENTS OF ABC 2014

2 OF 2

DRAWN: COB

CHECKED: COB

DATE: 22 OCT 24